



# Tahoe Donner Golf Course

Overall View

CART PATH REPLACEMENT PROJECT  
MARKUPS 02/21/2024

## Legend

-  12850 Northwoods Blvd
-  Tahoe Donner Golf Course

Downhill Ski Resort

Northwoods Blvd

12850 Northwoods Blvd

Tahoe Donner Golf Course

Tahoe Do

Northwoods Blvd

Google Earth



 

2000 ft



# Tahoe Donner Golf Course

Clubhouse Area

## Legend

-  12850 Northwoods Blvd
-  Tahoe Donner Golf Course
-  ASPHALT TO BE REPLACED
-  NEW ASPHALT



Google Earth

 
 
 
200 ft

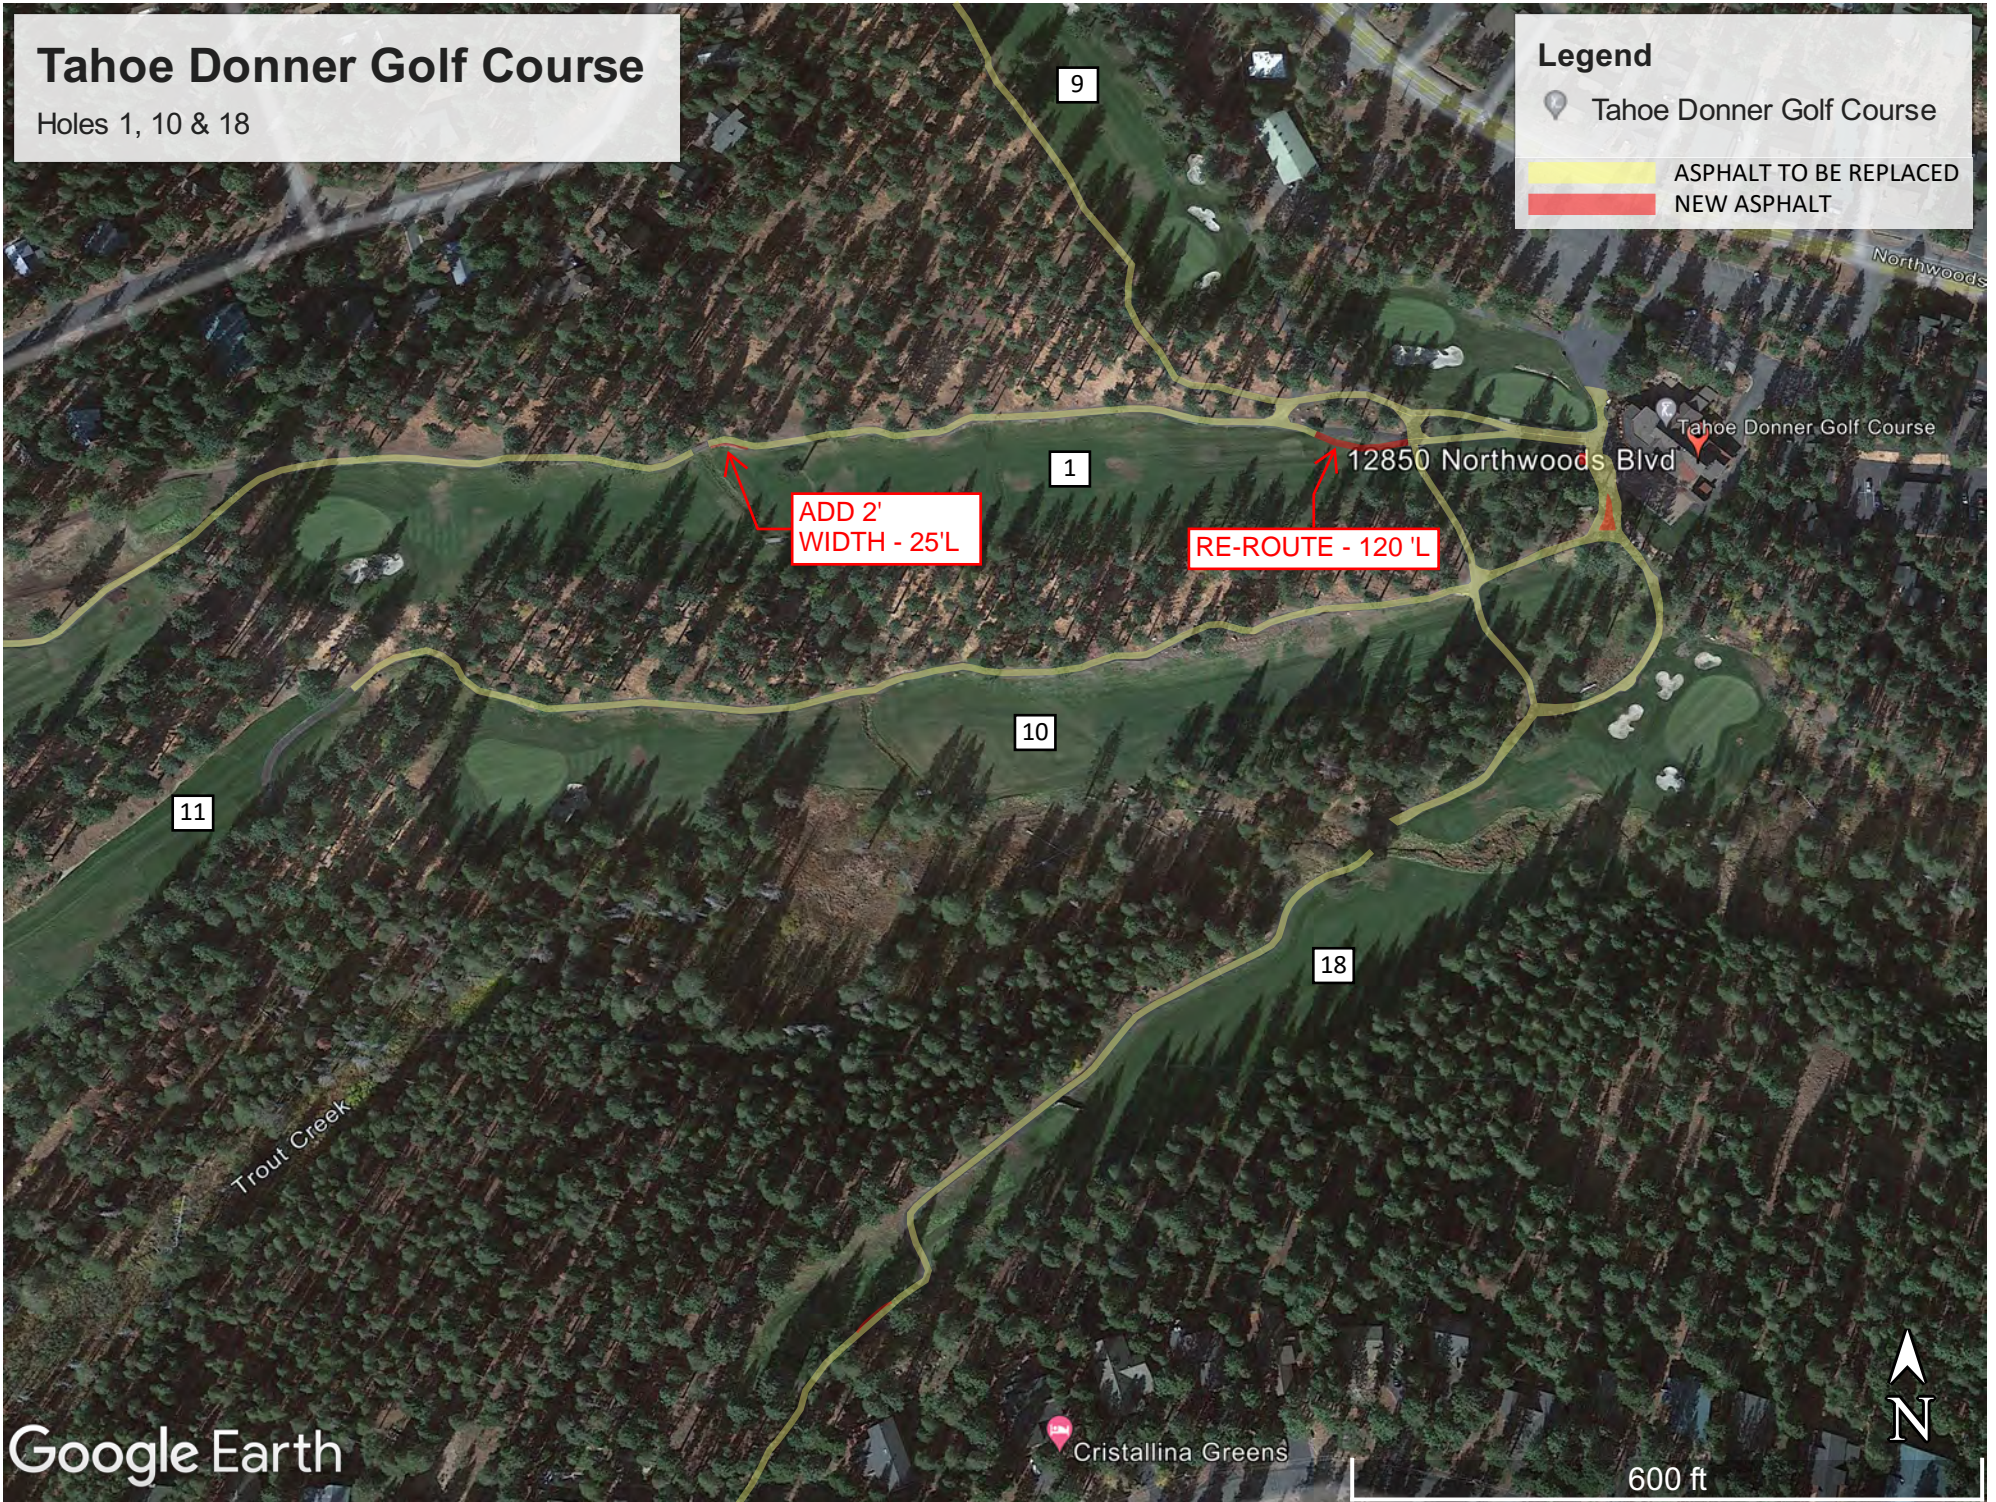


# Tahoe Donner Golf Course

Holes 1, 10 & 18

## Legend


 
 
-  Tahoe Donner Golf Course
-  ASPHALT TO BE REPLACED
-  NEW ASPHALT



# Tahoe Donner Golf Course

Holes 2 & 11

## Legend

-  Tahoe Donner Golf Course
-  ASPHALT TO BE REPLACED
-  NEW ASPHALT



TahoeDonner

800 ft

# Tahoe Donner Golf Course

Holes 3 & 4

## Legend

- ASPHALT TO BE REPLACED
- NEW ASPHALT

EXTEND 24" CULVERT 6' AND ADD ROCK ARMOR/SLOPE PROTECTION

RE-ROUTE - 130' L, PREP FOR SOD

RE-ROUTE - 120' L

Chalet Rd

Wonder Tribe Wedding Photography

Chateau Way

Ski View Loop

Google Earth

900 ft



# Tahoe Donner Golf Course

Holes 5, 6, 7 & 8

## Legend

- ASPHALT TO BE REPLACED
- NEW ASPHALT

RE-ROUTE - 134' L

ADD PATH - 67' L

ADJUST APPROACH TO BRIDGE - 50' L

RE-ROUTE - 101' L

6

7

8

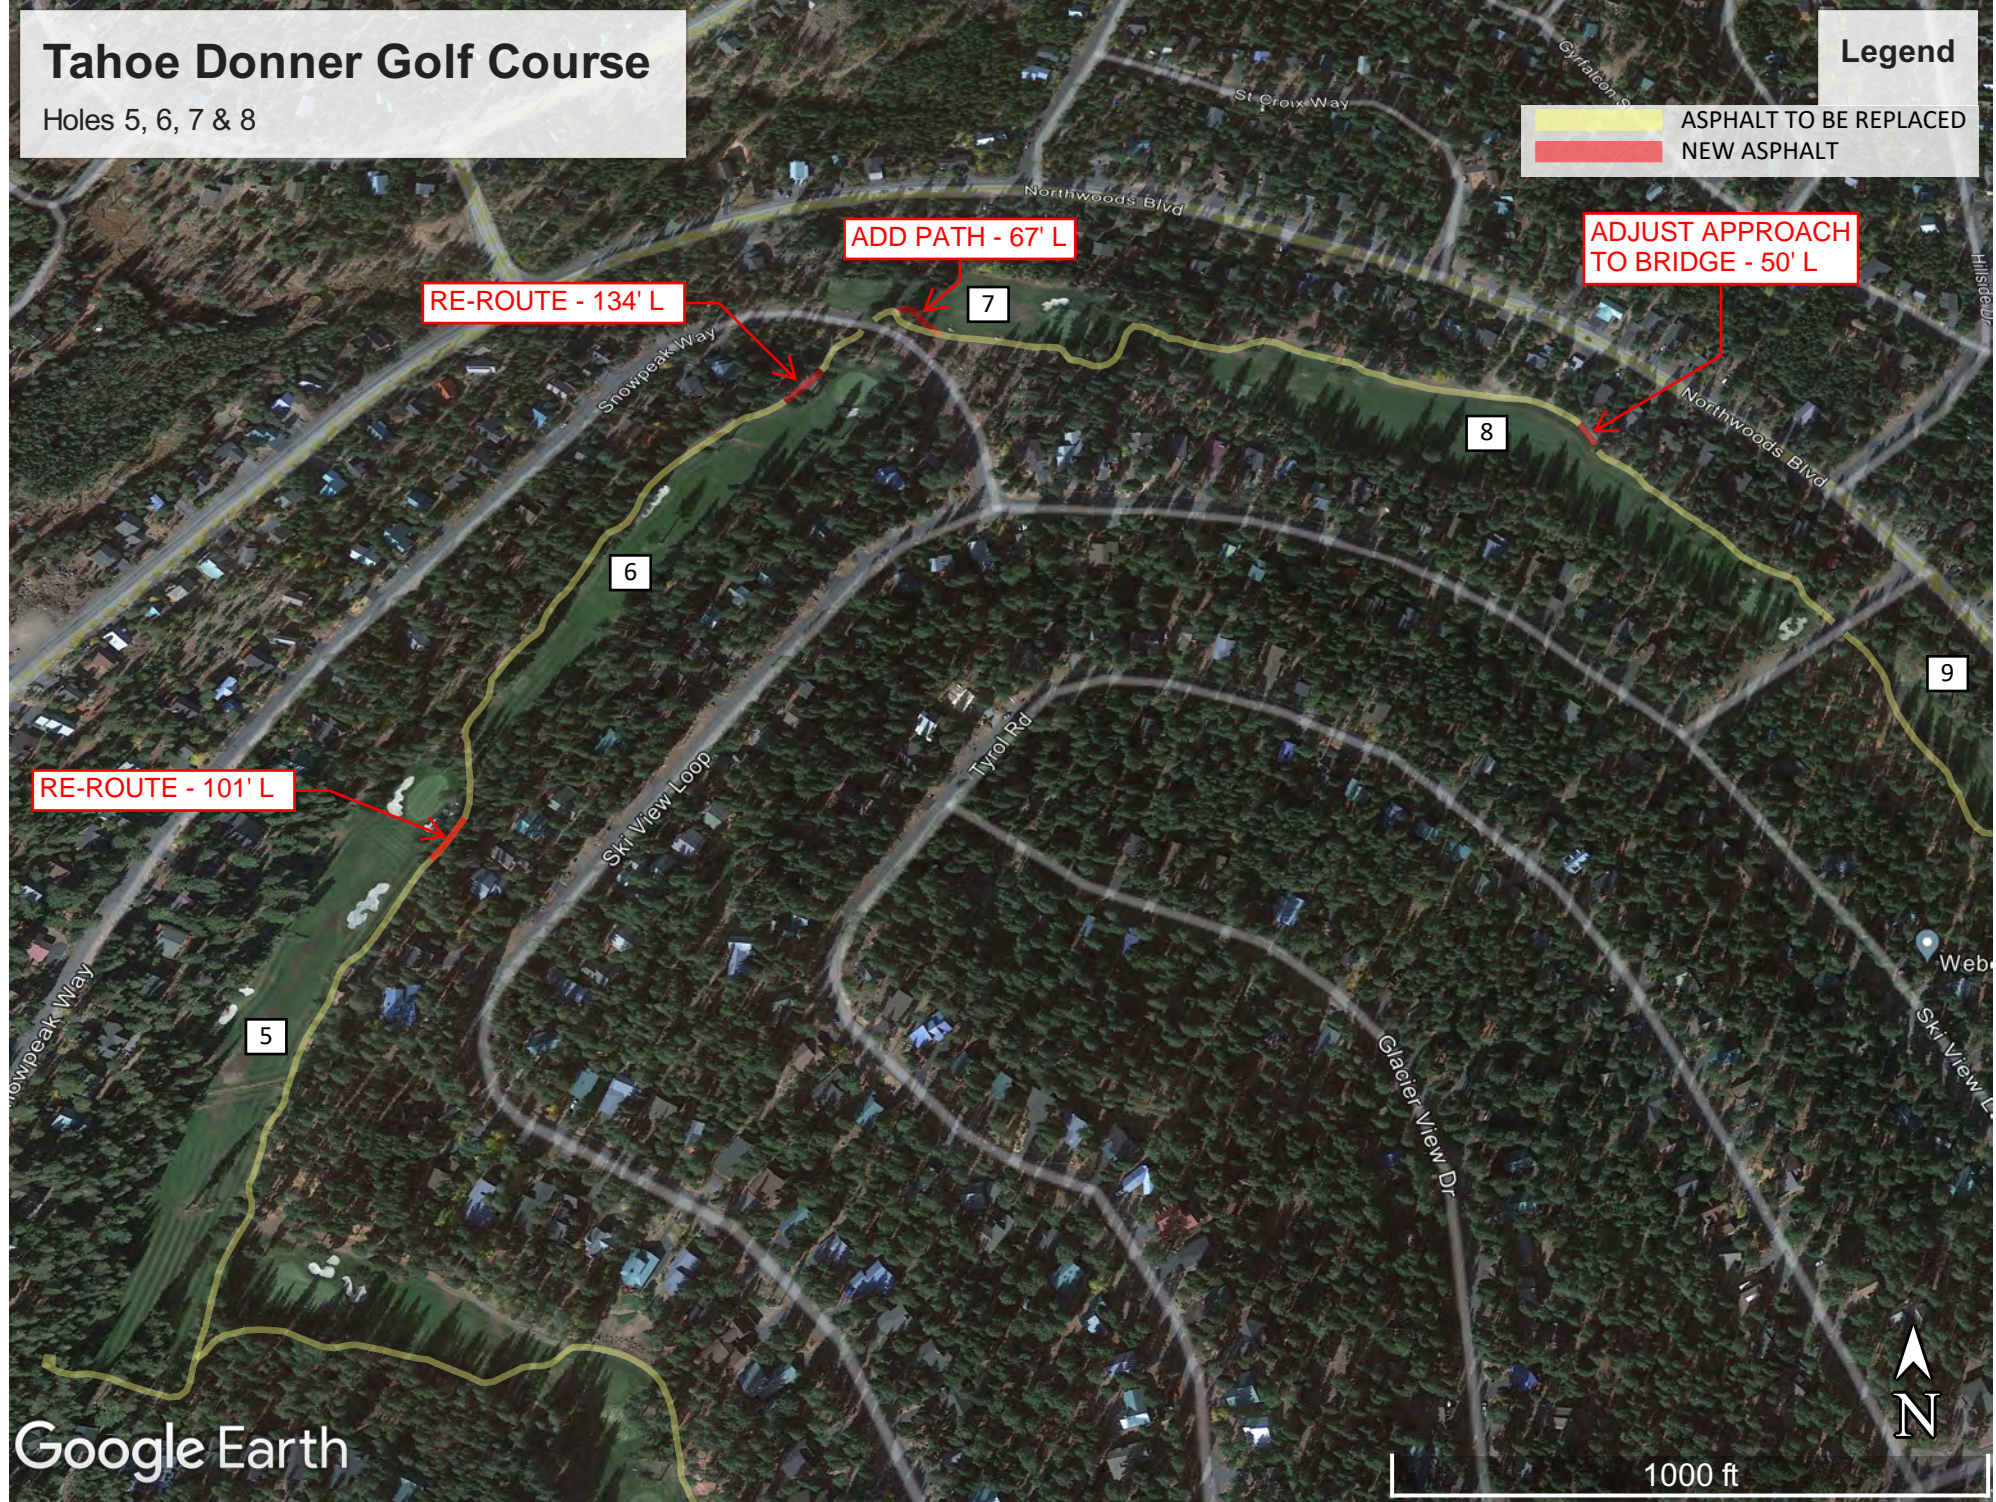
9

5

Google Earth



1000 ft



# Tahoe Donner Golf Course

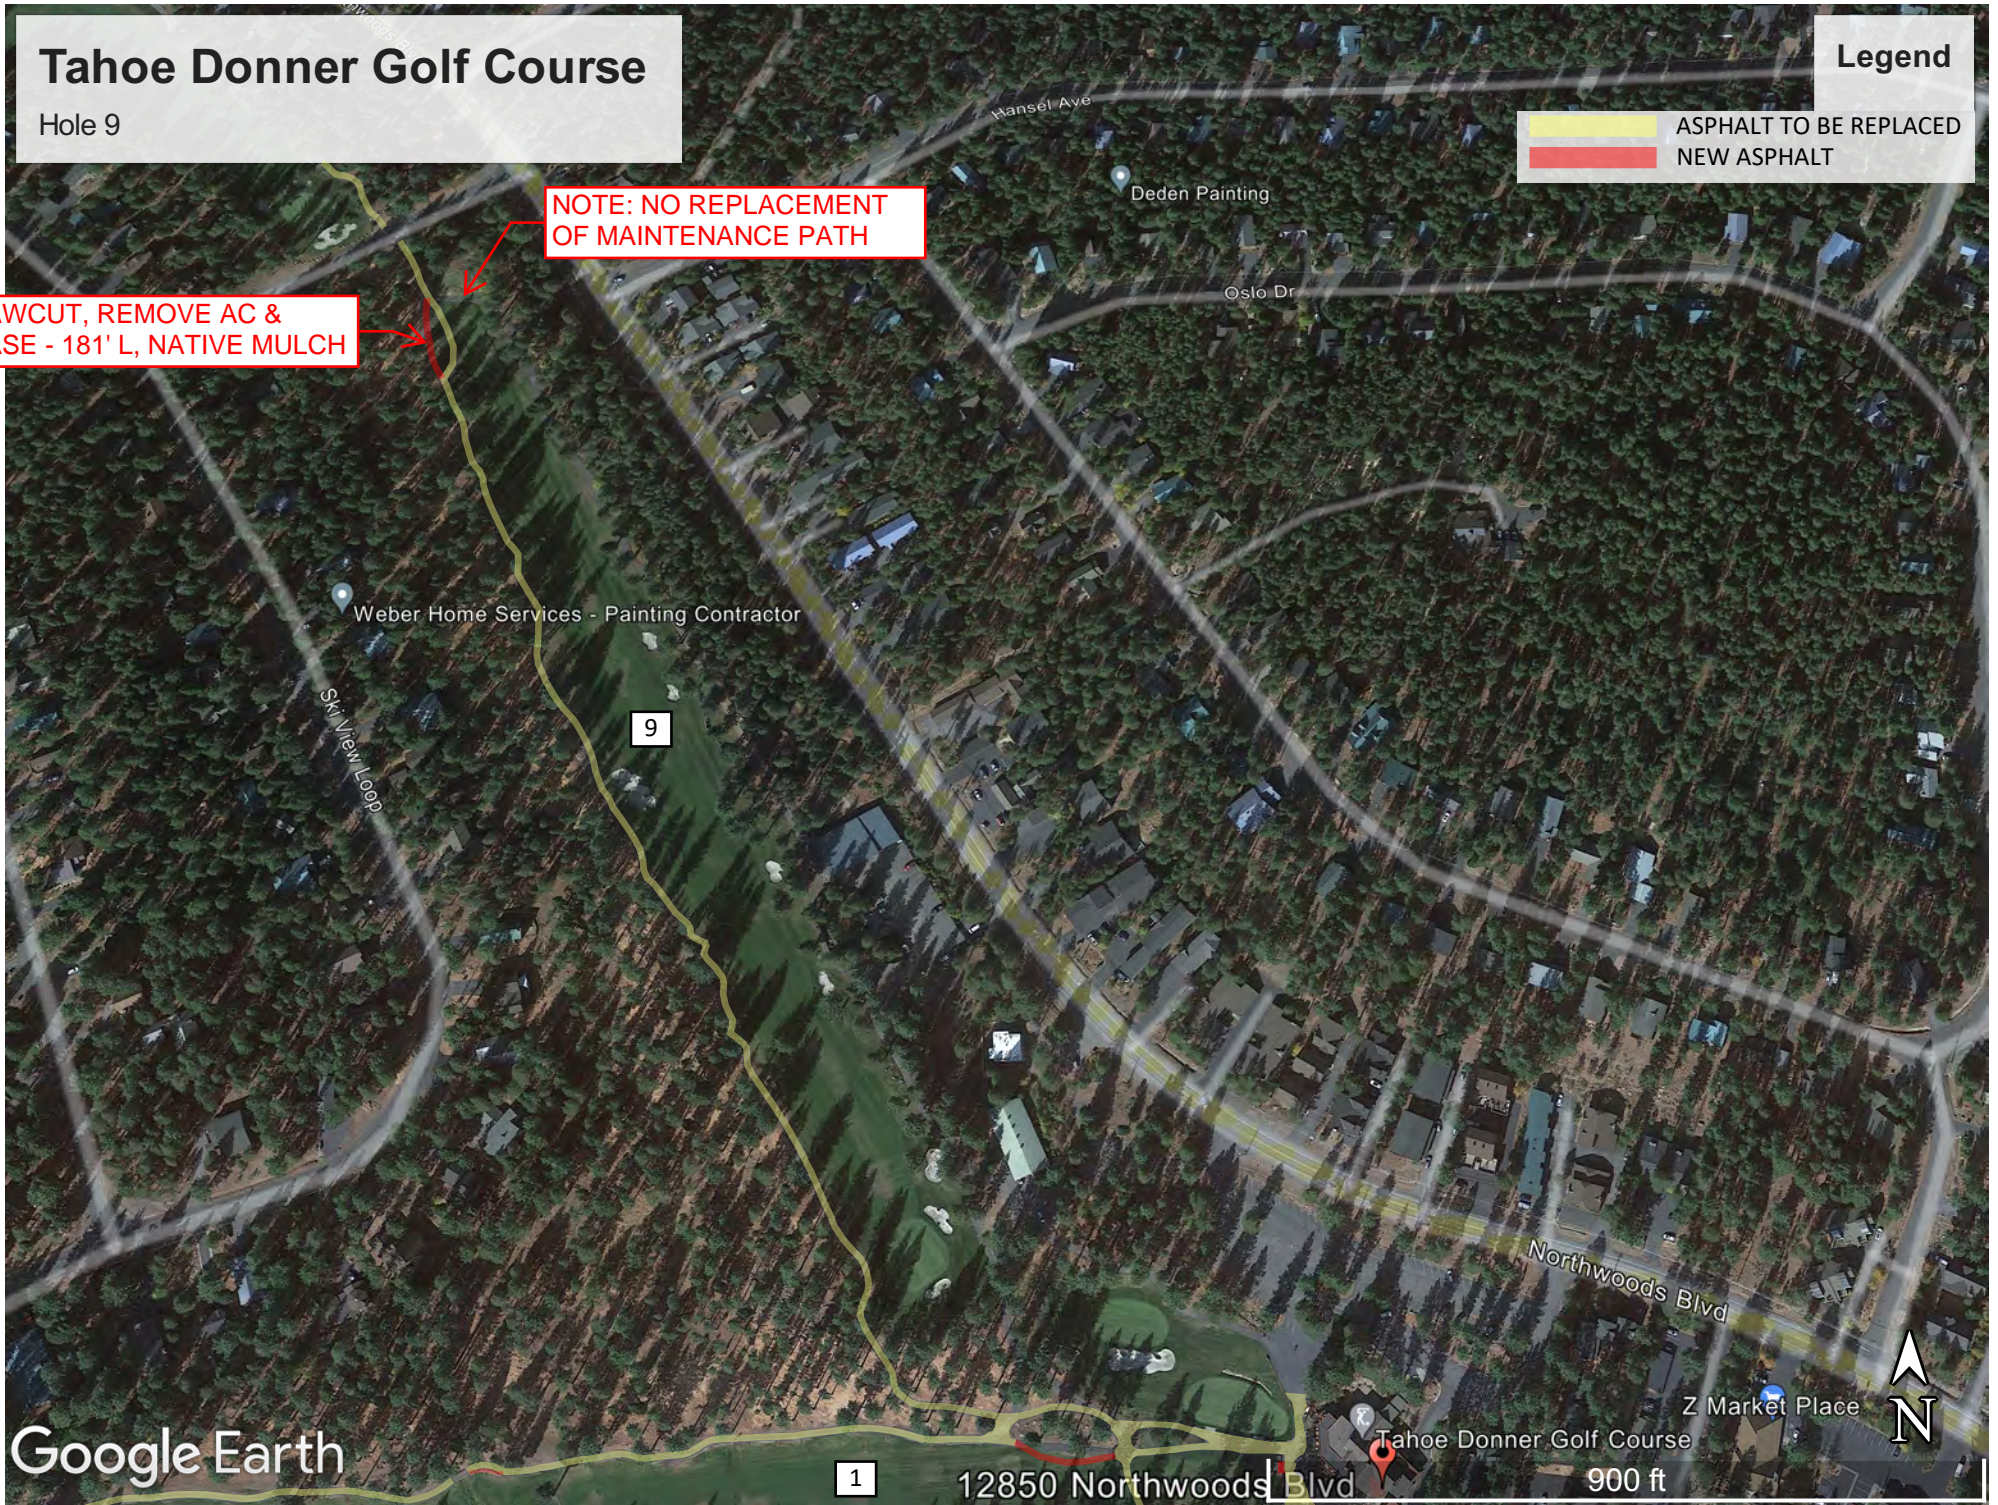
Hole 9

## Legend

- ASPHALT TO BE REPLACED
- NEW ASPHALT

NOTE: NO REPLACEMENT OF MAINTENANCE PATH

SAWCUT, REMOVE AC & BASE - 181' L, NATIVE MULCH



# Tahoe Donner Golf Course

Holes 12, 13 & 14

## Legend

- ASPHALT TO BE REPLACED
- NEW ASPHALT

ADD 2'  
WIDTH - 25'L

Norse Ave

13

12

Dog Gone It! Pet Care

Juneau Creek

14

Sun Valley Rd

Lucerne Ln

Google Earth



Swiss Ln 600 ft



# Tahoe Donner Golf Course

Holes 15 & 16

## Legend

- ASPHALT TO BE REPLACED
- NEW ASPHALT



Google Earth

800 ft



# Tahoe Donner Golf Course

Hole 17 & Connection to 18

## Legend

- ASPHALT TO BE REPLACED
- NEW ASPHALT

ADD 2'  
WIDTH - 25'L

ADD 2'  
WIDTH - 25'L

Google Earth



600 ft

